


**TREE PROTECTION DURING CONSTRUCTION- TYPE A**

N.T.S.

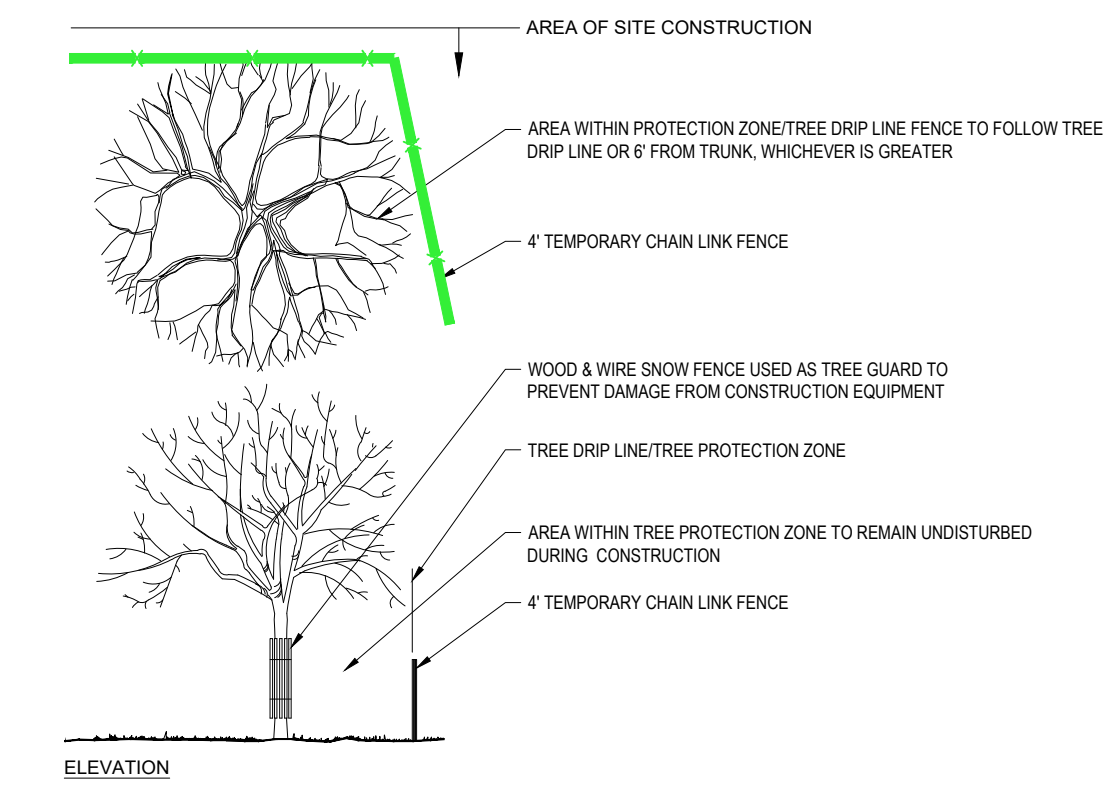

**TREE PROTECTION DURING CONSTRUCTION- TYPE B**


N.T.S.

THE FOLLOWING ADDITIONAL TREE PROTECTION MEASURES HAVE BEEN COMPLETED SINCE THE SITE MEETING WITH THE PLANNING BOARD ON 11/16/21:

- NORWAY MAPLE:
  - UNDER THE SUPERVISION OF A CERTIFIED ARBORIST, PREPARE AREA AROUND THE TREE FOR ROAD CONSTRUCTION
  - LOOSEN SOIL WITH AIR SPADE
  - ROOT PRUNE AND FERTILIZE ROOT ZONE
  - PLACE 4" DEPTH OF WOOD CHIPS OVER ROOT ZONE
- INSTALLED AN ADDITIONAL 400' OF "TREE PROTECTION" FENCING
- RELOCATED SECTION OF THE LIMIT OF WORK FENCE TO PREVENT CONSTRUCTION ACTIVITY OVER ROOT ZONES OF EXISTING TREES TO REMAIN.

**LEGEND** (REVISED 1/6/22-ADD LIMIT OF WORK LINE AND ROOT ZONE PROTECTION)


- TYPE A TREE PROTECTION
- TYPE B TREE PROTECTION
- TREE TO BE REMOVED
- ADDITIONAL TREE TO BE REMOVED
- LIMIT OF WORK LINE
- EXISTING TREE ROOT ZONE PROTECTION

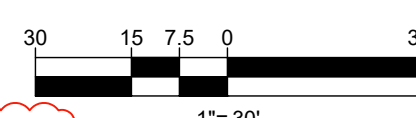

**TREE REMOVAL PLAN REVISED 1-14-2022 BASED ON UPDATED ARBORIST REPORT DATED JULY 20, 2021 BY TREE SPECIALISTS, INC. AND COMMENTS RECEIVED DURING 11/16/21 SITE WALK WITH PLANNING BOARD**

**CONTRACTOR TO REVIEW AND COMPLY WITH ALL RECOMMENDATIONS BY ARBORIST AS OUTLINED IN THE ARBORIST CONSULTING REPORT DATED 09/13/2016 BY TREE SPECIALISTS, INC.**

LANDSCAPE ARCHITECT  
**BOHLER**  
352 TURNPIKE ROAD  
SOUTHBOROUGH, MA  
(508)480-9900

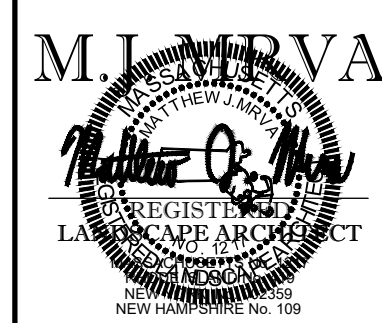

REVISION RECORD	
NO.	DATE

**Civil & Environmental Consultants, Inc.**  
31 Belkows Road - Raynham, MA 02767  
Ph: 774.501.2176 • 866.312.2024 • Fax: 774.501.2669  
www.civilinc.com

**SEB WESTON VILLAGE, LLC**  
**THE VILLAGE AT SILVER HILL**  
**SITE PLAN REVIEW APPLICATION**  
**255 MERRIAM ST & 11 HALLETT HILL ROAD**  
**WESTON, MASSACHUSETTS**

**TREE REMOVAL AND PROTECTION PLAN**

DATE:	MARCH 19, 2021	DRAWN BY:	TWR
PROJECT NO.:	174-238	CHECKED BY:	KPS
APPROVED BY:			

DRAWING NO.: **13**

SHEET OF